


# FALMOUTH PASSMORE EDWARDS BUILDING - Initial concept design for consultation and discussion.

The drawings shown here are a starting point for discussing the future adaptation of this building.

A cultural and creative transformation will help secure its long-term future, delivering essential infrastructure to support sustainability and safeguard this unique and significant heritage asset.


The potential changes illustrated are simply to begin a conversation. The red lines mark areas of the existing building that may be considered for removal.

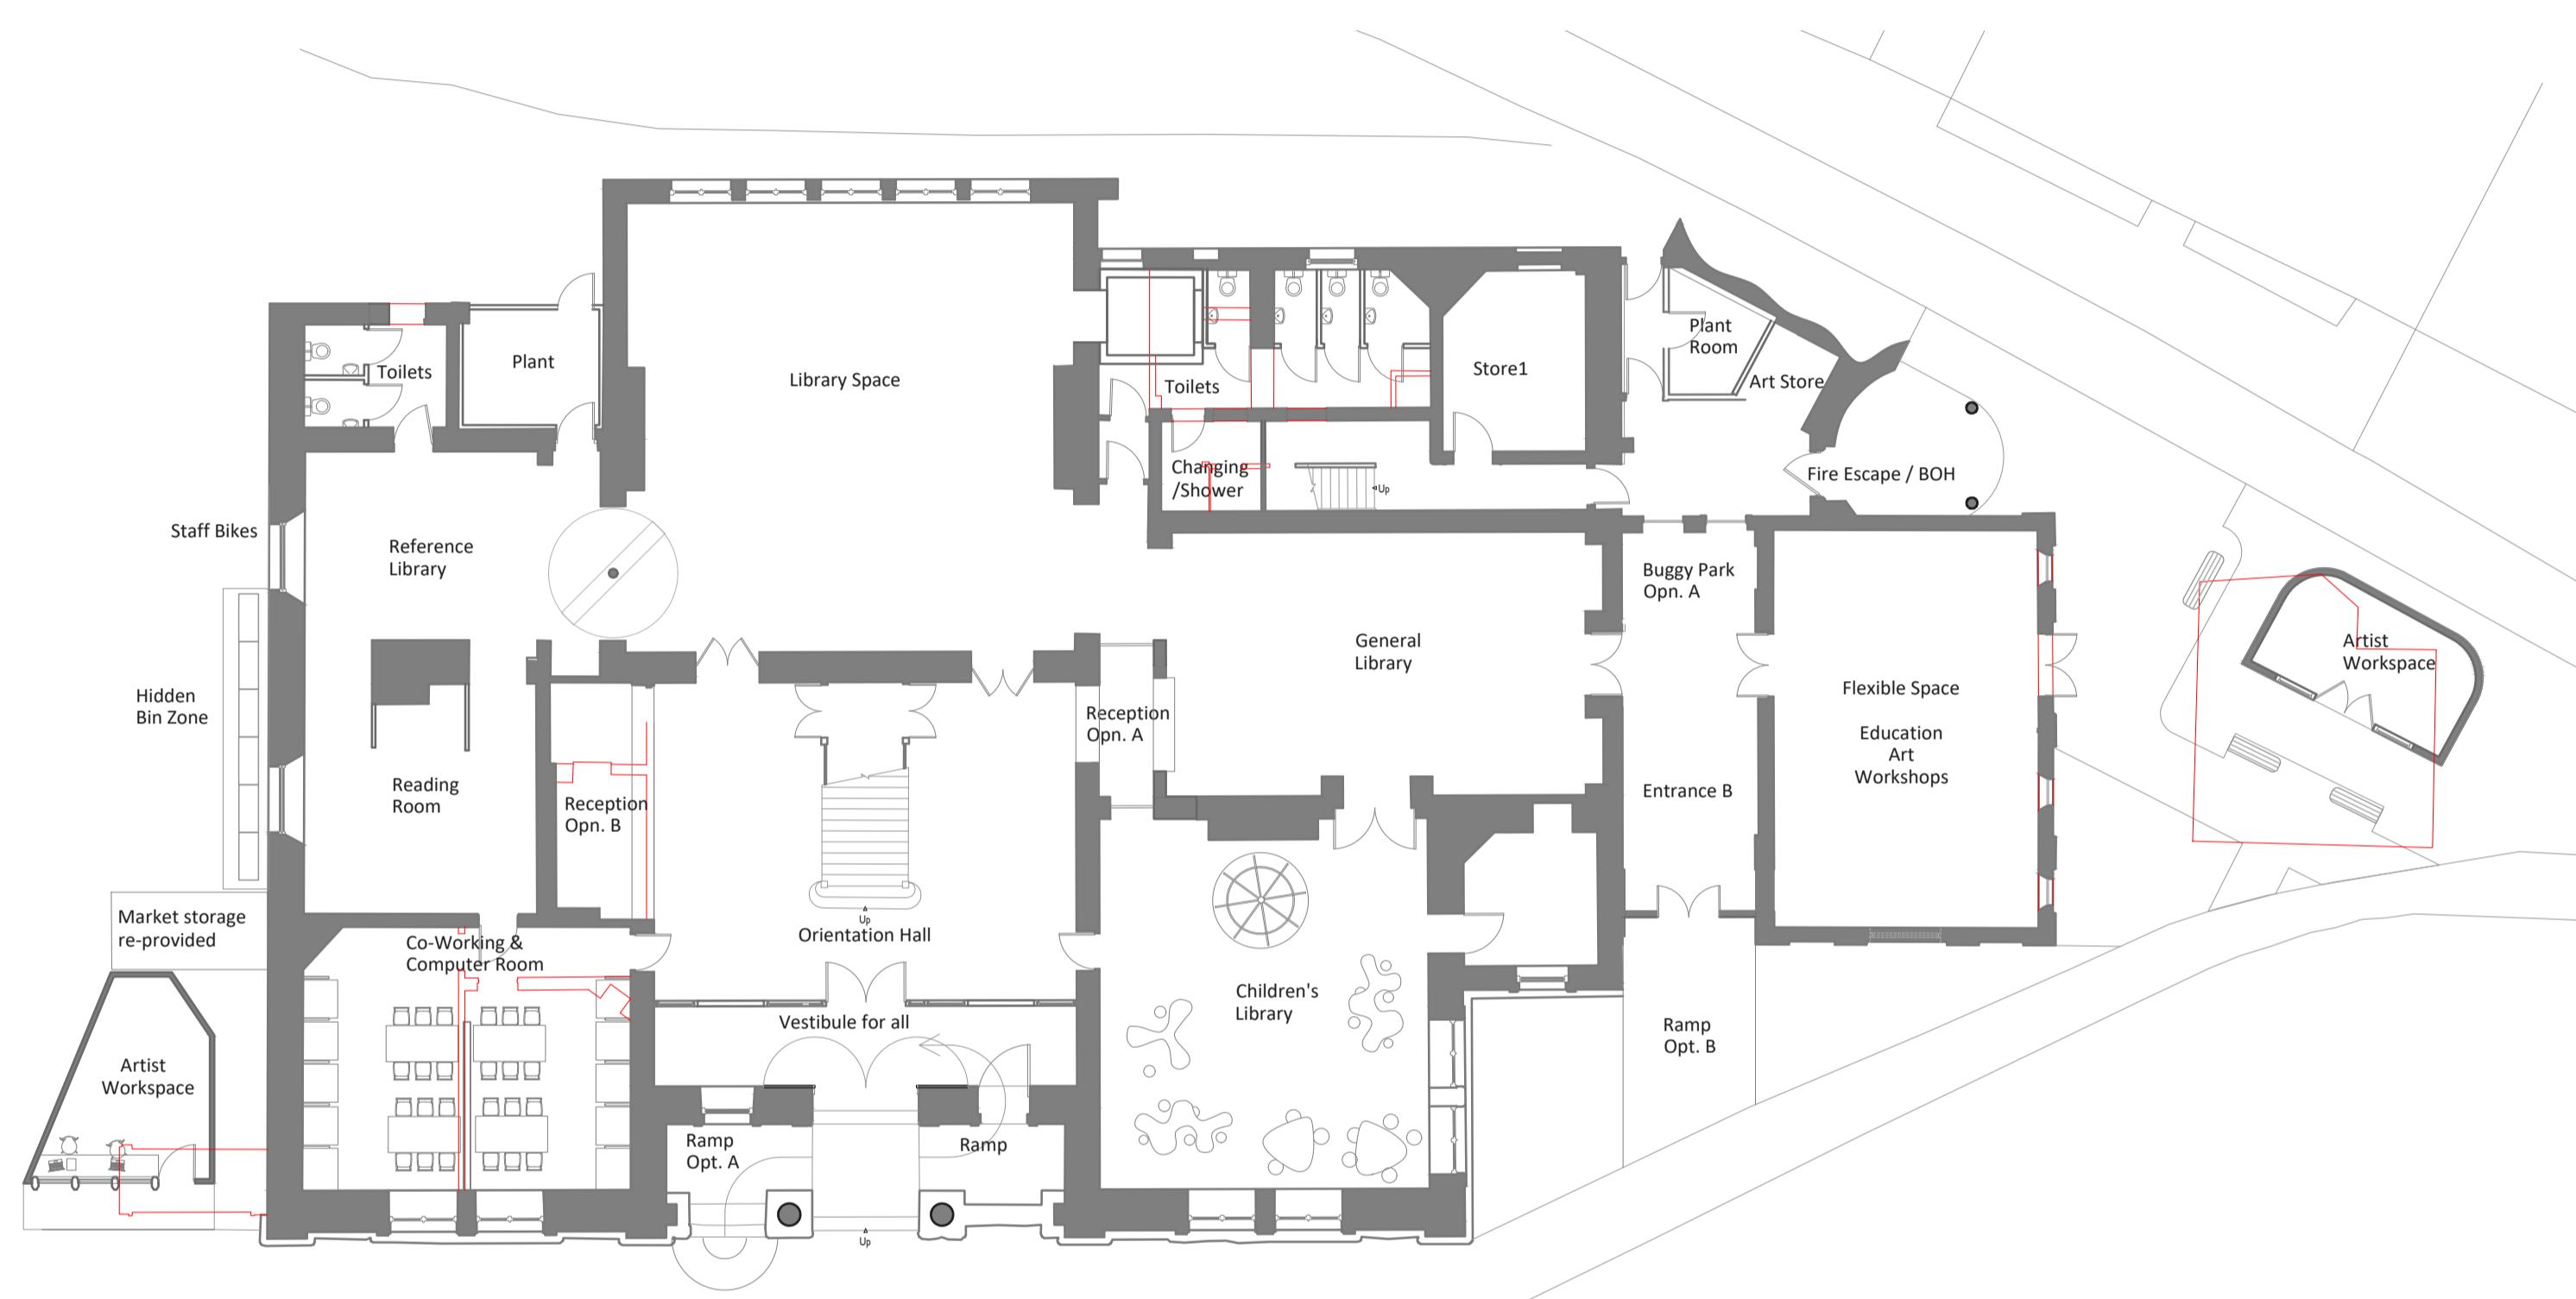


Ground Floor



First Floor

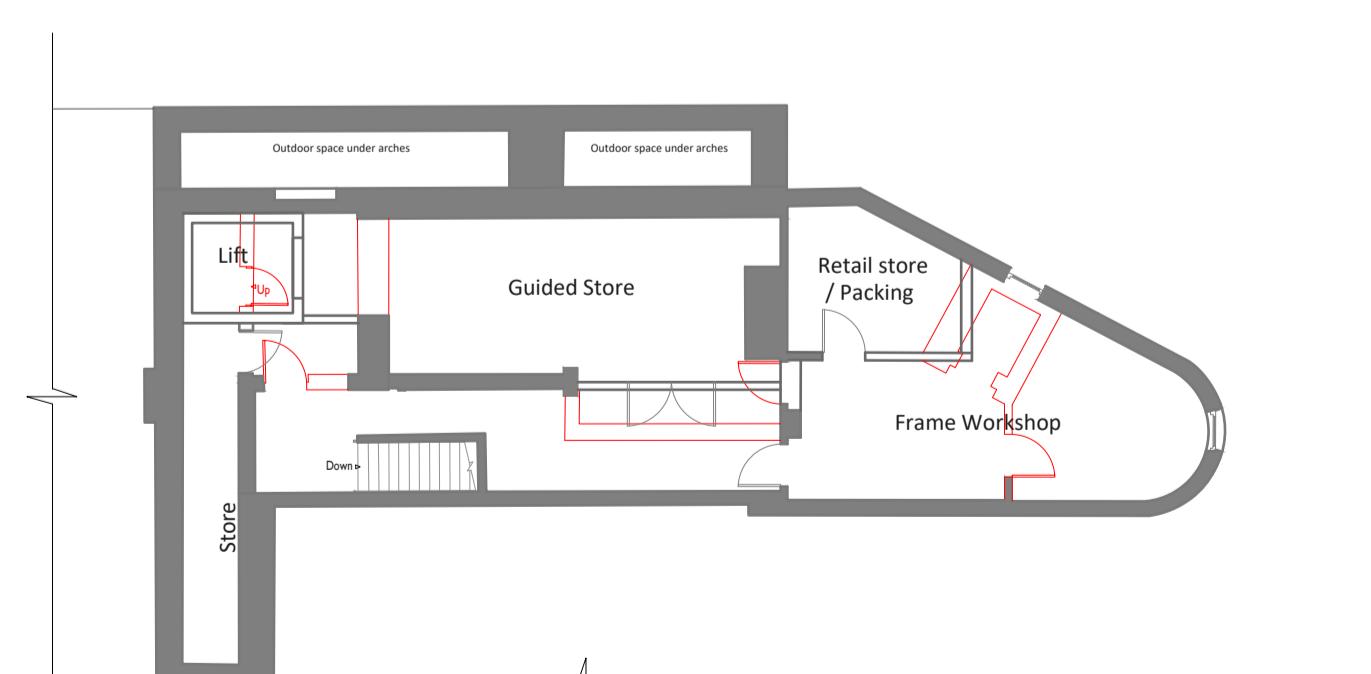

Mezzanine Floor

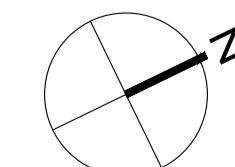

Scale 1:150  
0m 5 10 20



Roof Floor